




1 / NORTH SIDE ELEVATION
SCA/100



2 / WEST SIDE ELEVATION
SCA/100

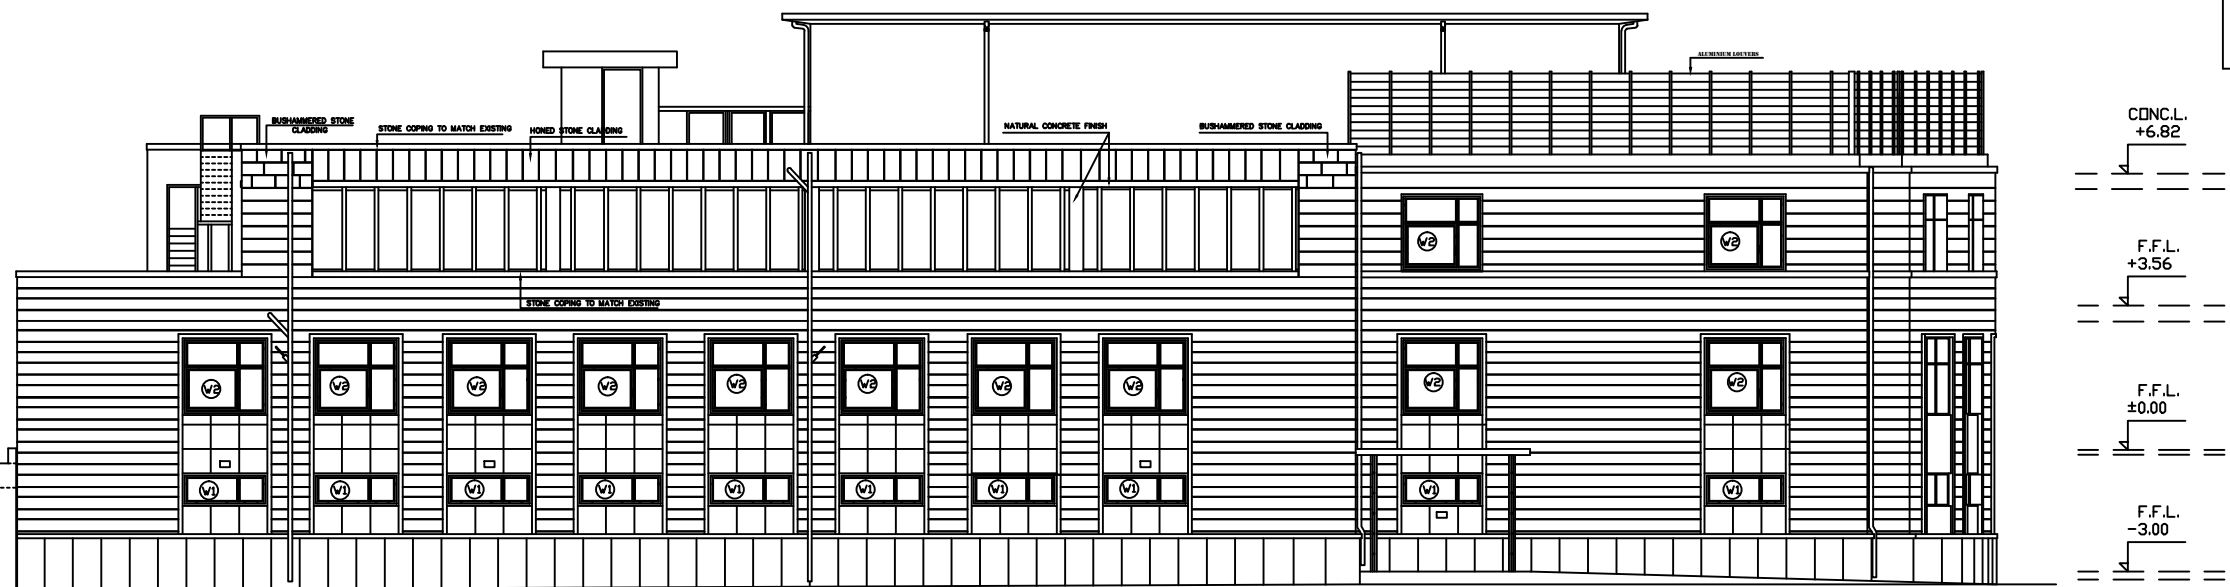


3 / EAST SIDE ELEVATION
SCA/100

REVISIONS

| REV. | DESCRIPTION | DATE |
|------|-------------|------|
| | | |

KEY PLAN

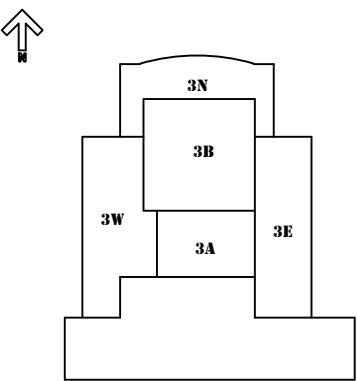

EMPLOYER

A U B
THE AMERICAN
UNIVERSITY OF BEIRUT

ENGINEER

H L W
HAINES-LUNDBERG-WAEHLER
NEW YORK

Khatib & Alami
CONSOLIDATED ENGINEERING COMPANY
BEIRUT-LEBANON

CONTRACTOR

F. KARAGULLA
ENGINEERING &
GENERAL CONTRACTING
BEIRUT-LEBANON

AS-BUILT
DRAWING
(ARCHITECTURAL)

| | | | |
|---------------|---------------------------------|------------|----------|
| SCALE | 1/100 | DRAWN BY | I.FARHAT |
| DATE | OCT. 11, 1996 | CHECKED BY | N.A. |
| DRAWING TITLE | NORTH WEST & EAST ELEVATIONS | | |