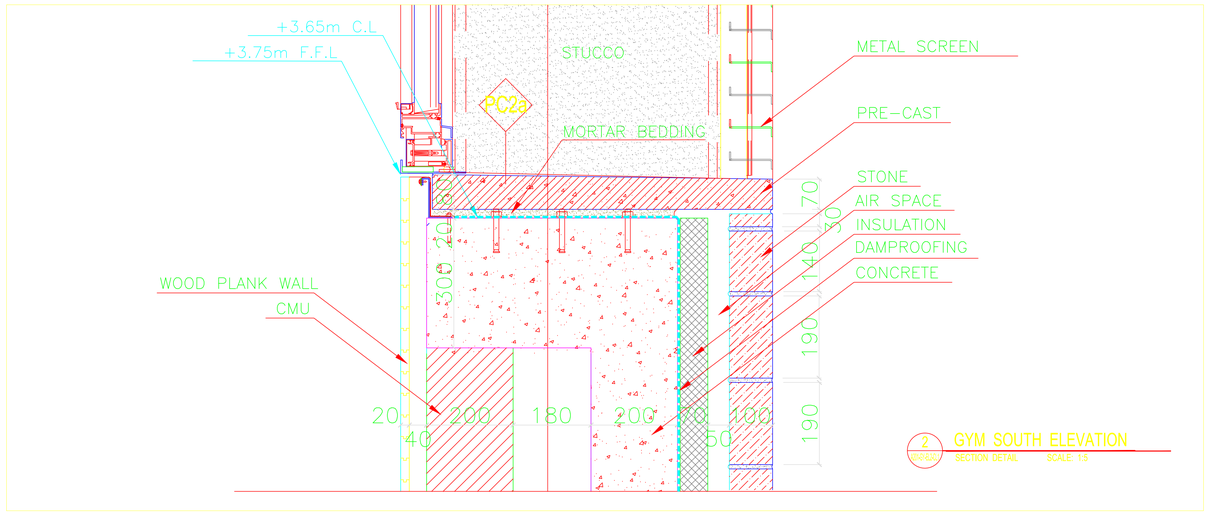

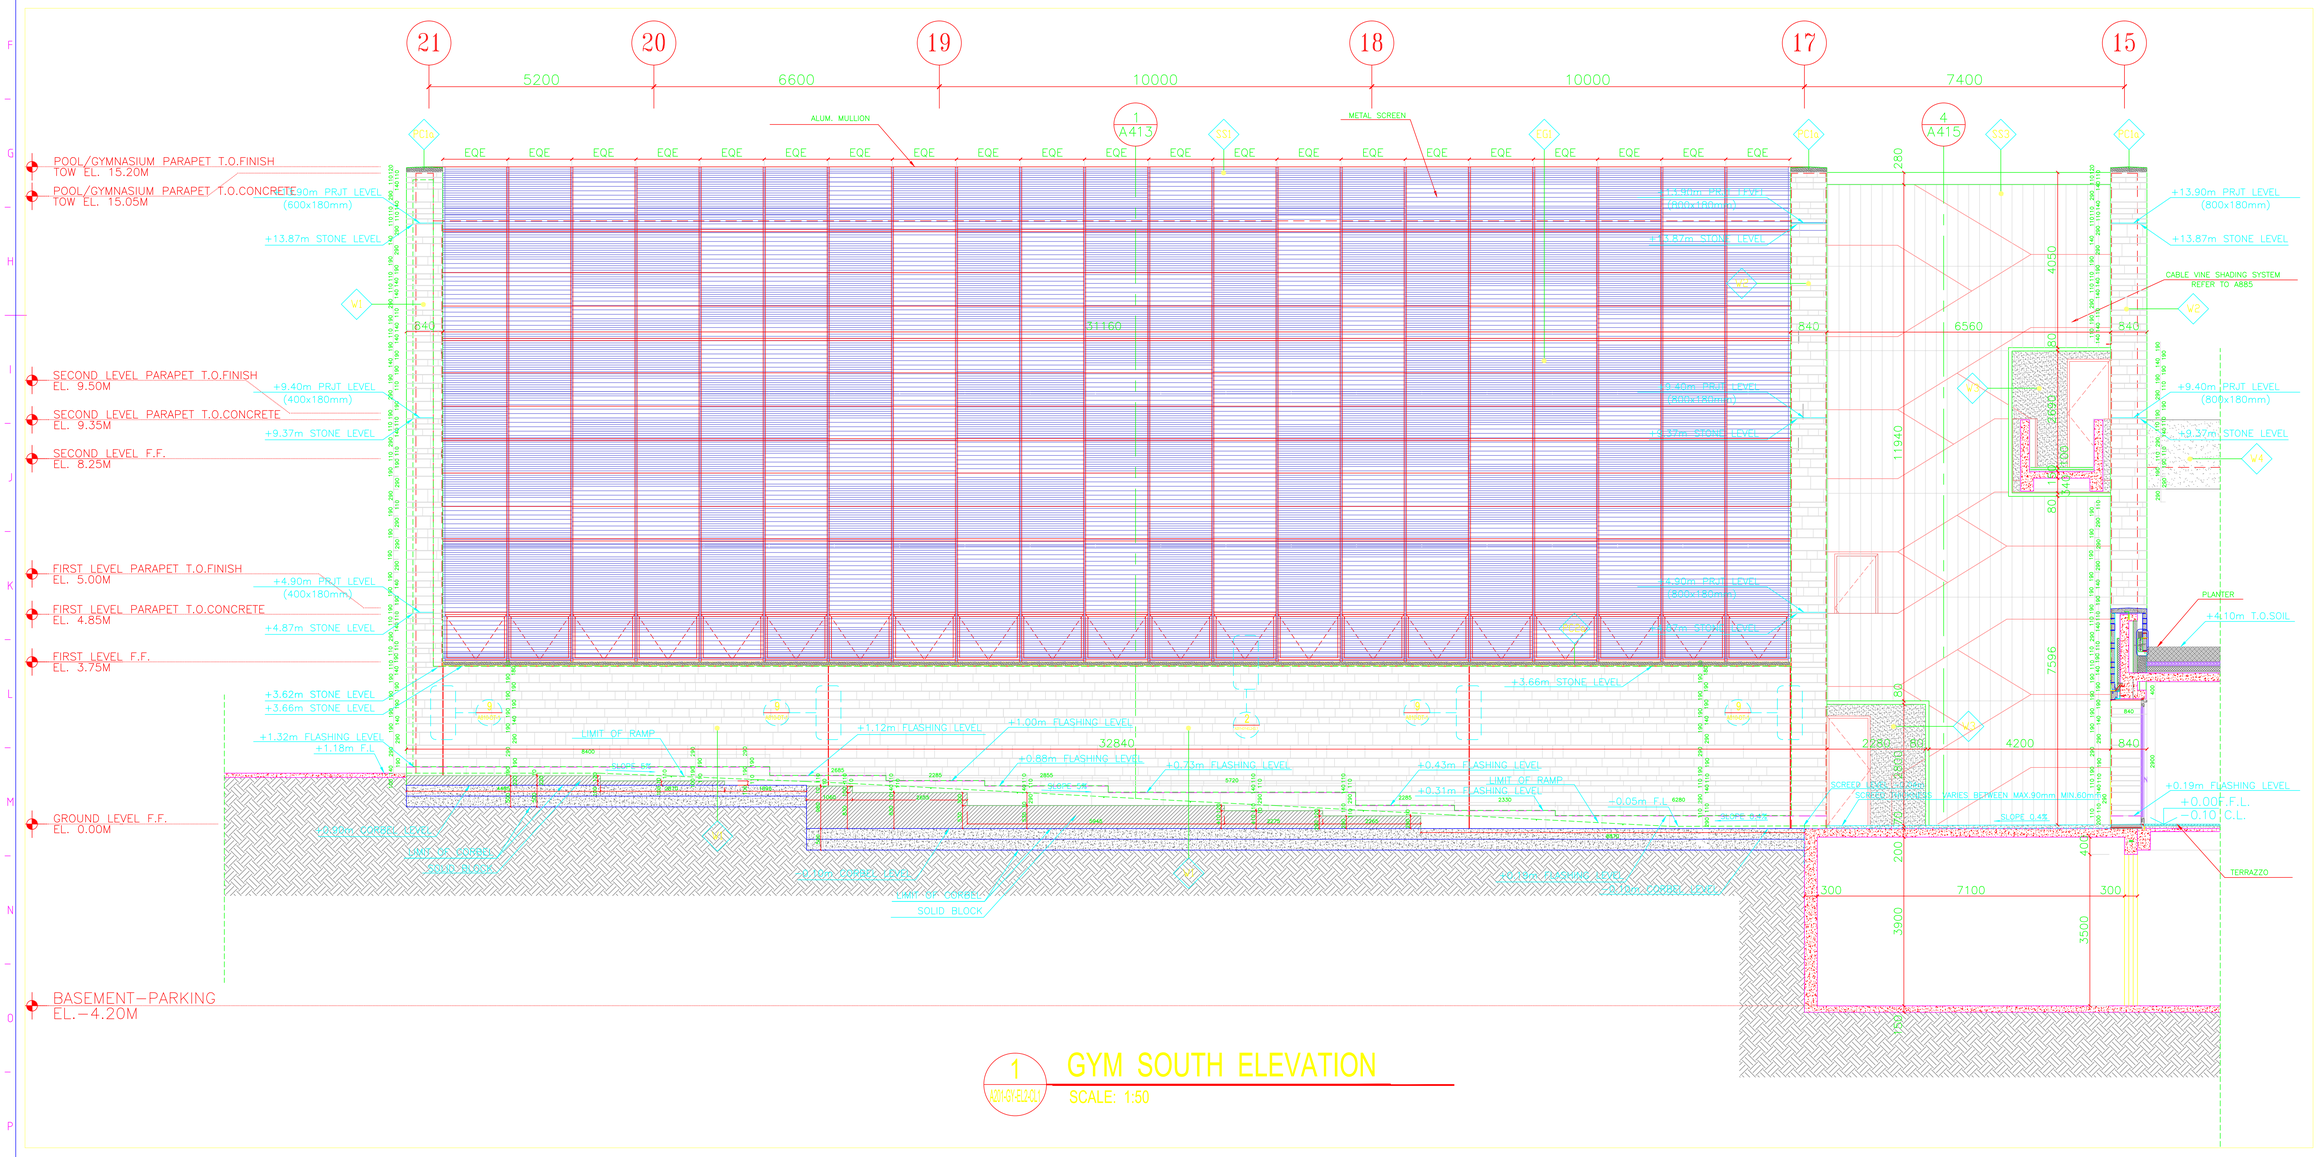

VJAA

ARCHITECT
Vincent James Associates Architects
400 First Avenue North, Suite 120
Minneapolis, Minnesota 55401
(612) 672-6370
(612) 672-6380 Fax

Samir Kharaliah & Partners
P.O. Box 160-0220
Hazmieh, Lebanon
+961 (5) 452 793
+961 (5) 457 271 Fax

LANDSCAPE ARCHITECT
Hargreaves Associates
100 Varick Street, Suite 1304
New York, New York 10014
(212) 337-9973
(212) 337-9972 Fax

ENERGY AND COMFORT CONCEPT
Transplan Energietechnik GmbH
Curiestrasse 2
Stuttgart, Germany 70563
+49 (711) 67976-0
+49 (711) 6796-11 Fax

STRUCTURAL
Samir Kharaliah & Partners
P.O. Box 160-0220
Hazmieh, Lebanon
+961 (5) 452 793
+961 (5) 457 271 Fax

MECHANICAL/ELECTRICAL
Barbanel Liban s.a.l
P.O. Box 70-1116
Antelias, Lebanon
+961 (4) 413 953
+961 (4) 523 079/080 Fax

CIVIL
Wael A. Kayyali
Boubess Commercial Center, 4th Floor
Beirut, Lebanon
+961 (3) 622 728
+961 (1) 318 911 Fax

INTERNATIONAL COST CONSULTANTS AND QUANTITY SURVEYORS
D.G. Jones & Partners
Verdun Centre, 11th Floor
Beirut, Lebanon
+961 (1) 353 501 / 2
+961 (1) 343 802 Fax

CONTRACTOR

KARAGULLA ENGINEERING & CONTRACTING S.A.L.
SIN EL FIL 42400/475

SUBCONTRACTOR

AUB American University of Beirut
Facilities Planning and Design Unit

KEY PLAN

PROJECT NAME:
Charles Hostler student center and corniche frontage
PROJECT NO.: E1TOC-005

AS-BUILT DRAWING
(ARCHITECTURAL)

NO. | REVISION | DATE

REFERENCE DRAWINGS:

DRAWN BY:
ARCHITECTURAL: L.NAWAR STRUCTURAL: M.ELNASIM
ELECTRICAL: CAPELEC MECHANICAL: MEO

APPROVAL OF END USER:
APPROVAL OF EHS&RM:
OTHER APPROVALS:
APPROVAL OF FITO:

SCALE REFERENCE: ANSI/ISO/A1

TITLE:
REVISION NUMBER: 00
SOUTH ELAVATION GYM.

DATE OF ISSUE: 1/1/2006 SCALE: 1:50

A201-GY-EL2-CL1

SHEET: -- OF --