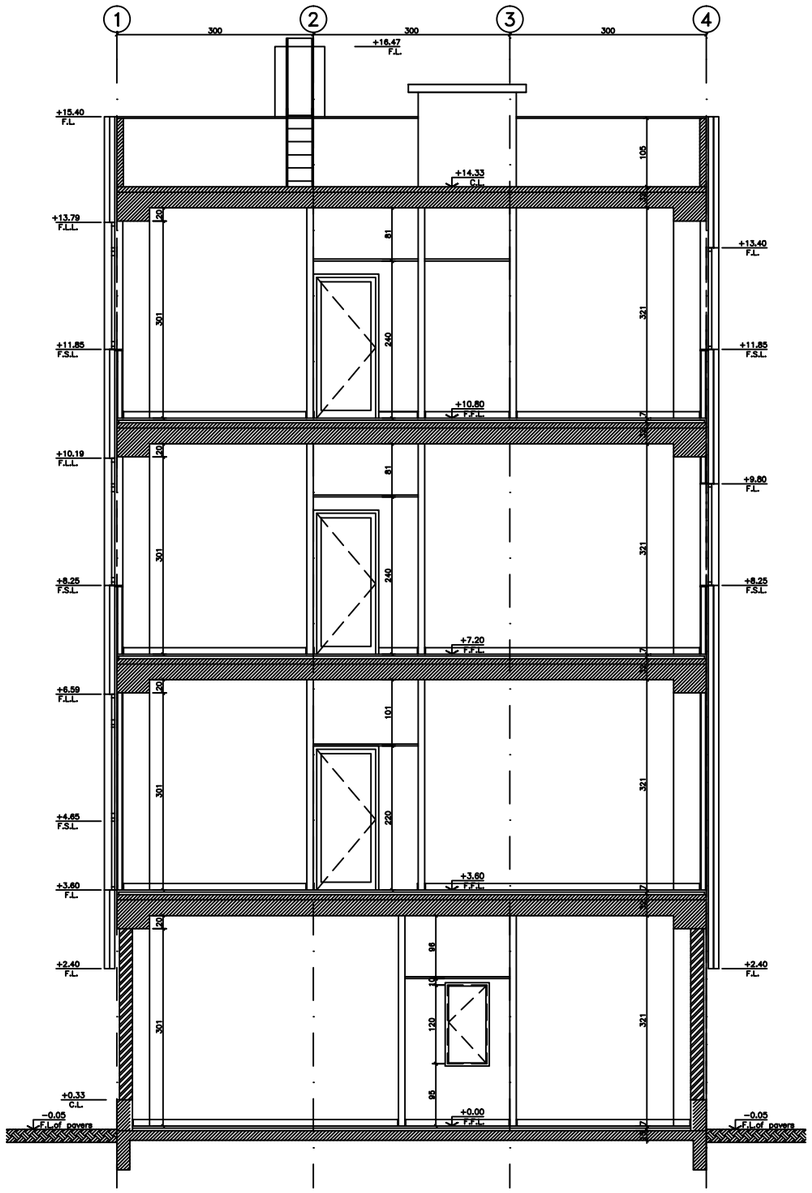

Phone: +961 1 851971 - Fax: +961 1 851776 - Email: info@bawader.com
architects
Bawader Architects
Mkaal bldg. - 5th floor - South Sodeco blvd. - Hamra - Beirut 2033 5301
بواذر للهندسة المعمارية - مكال بلدنغ - الطابق الخامس - سوق سوديكو الجنوبي - الحمرا - بيروت

NOTES

AUB American University of Beirut

Facilities Planning and Design Unit

CONTRACTOR
TRUST
Contracting & Trading
Tel : 009613 382640
Fax : 009613 395602
email : trustcf@inco.com.lb

PROJECT NAME:
FACILITY SATELLITE 2

PROJECT NO: FPDU 000

NO	REVISION	DATE

REFERENCE DRAWINGS:

DRAWN BY: Bawader Architects
ARCHITECTURAL: M.A. STRUCTURAL:
ELECTRICAL: MECHANICAL:

APPROVAL OF END USER:
APPROVAL OF EHS&RM:
OTHER APPROVALS:
APPROVAL OF FPDU:

ACAD REFERENCE:fpdu000xx0000

REVISION NUMBER: 00

TITLE:

Section AA
As Built

DATE OF DWG: 04/01/2013 SCALE: 1/50

A 302

SHEET: 00 OF 00