NOTES

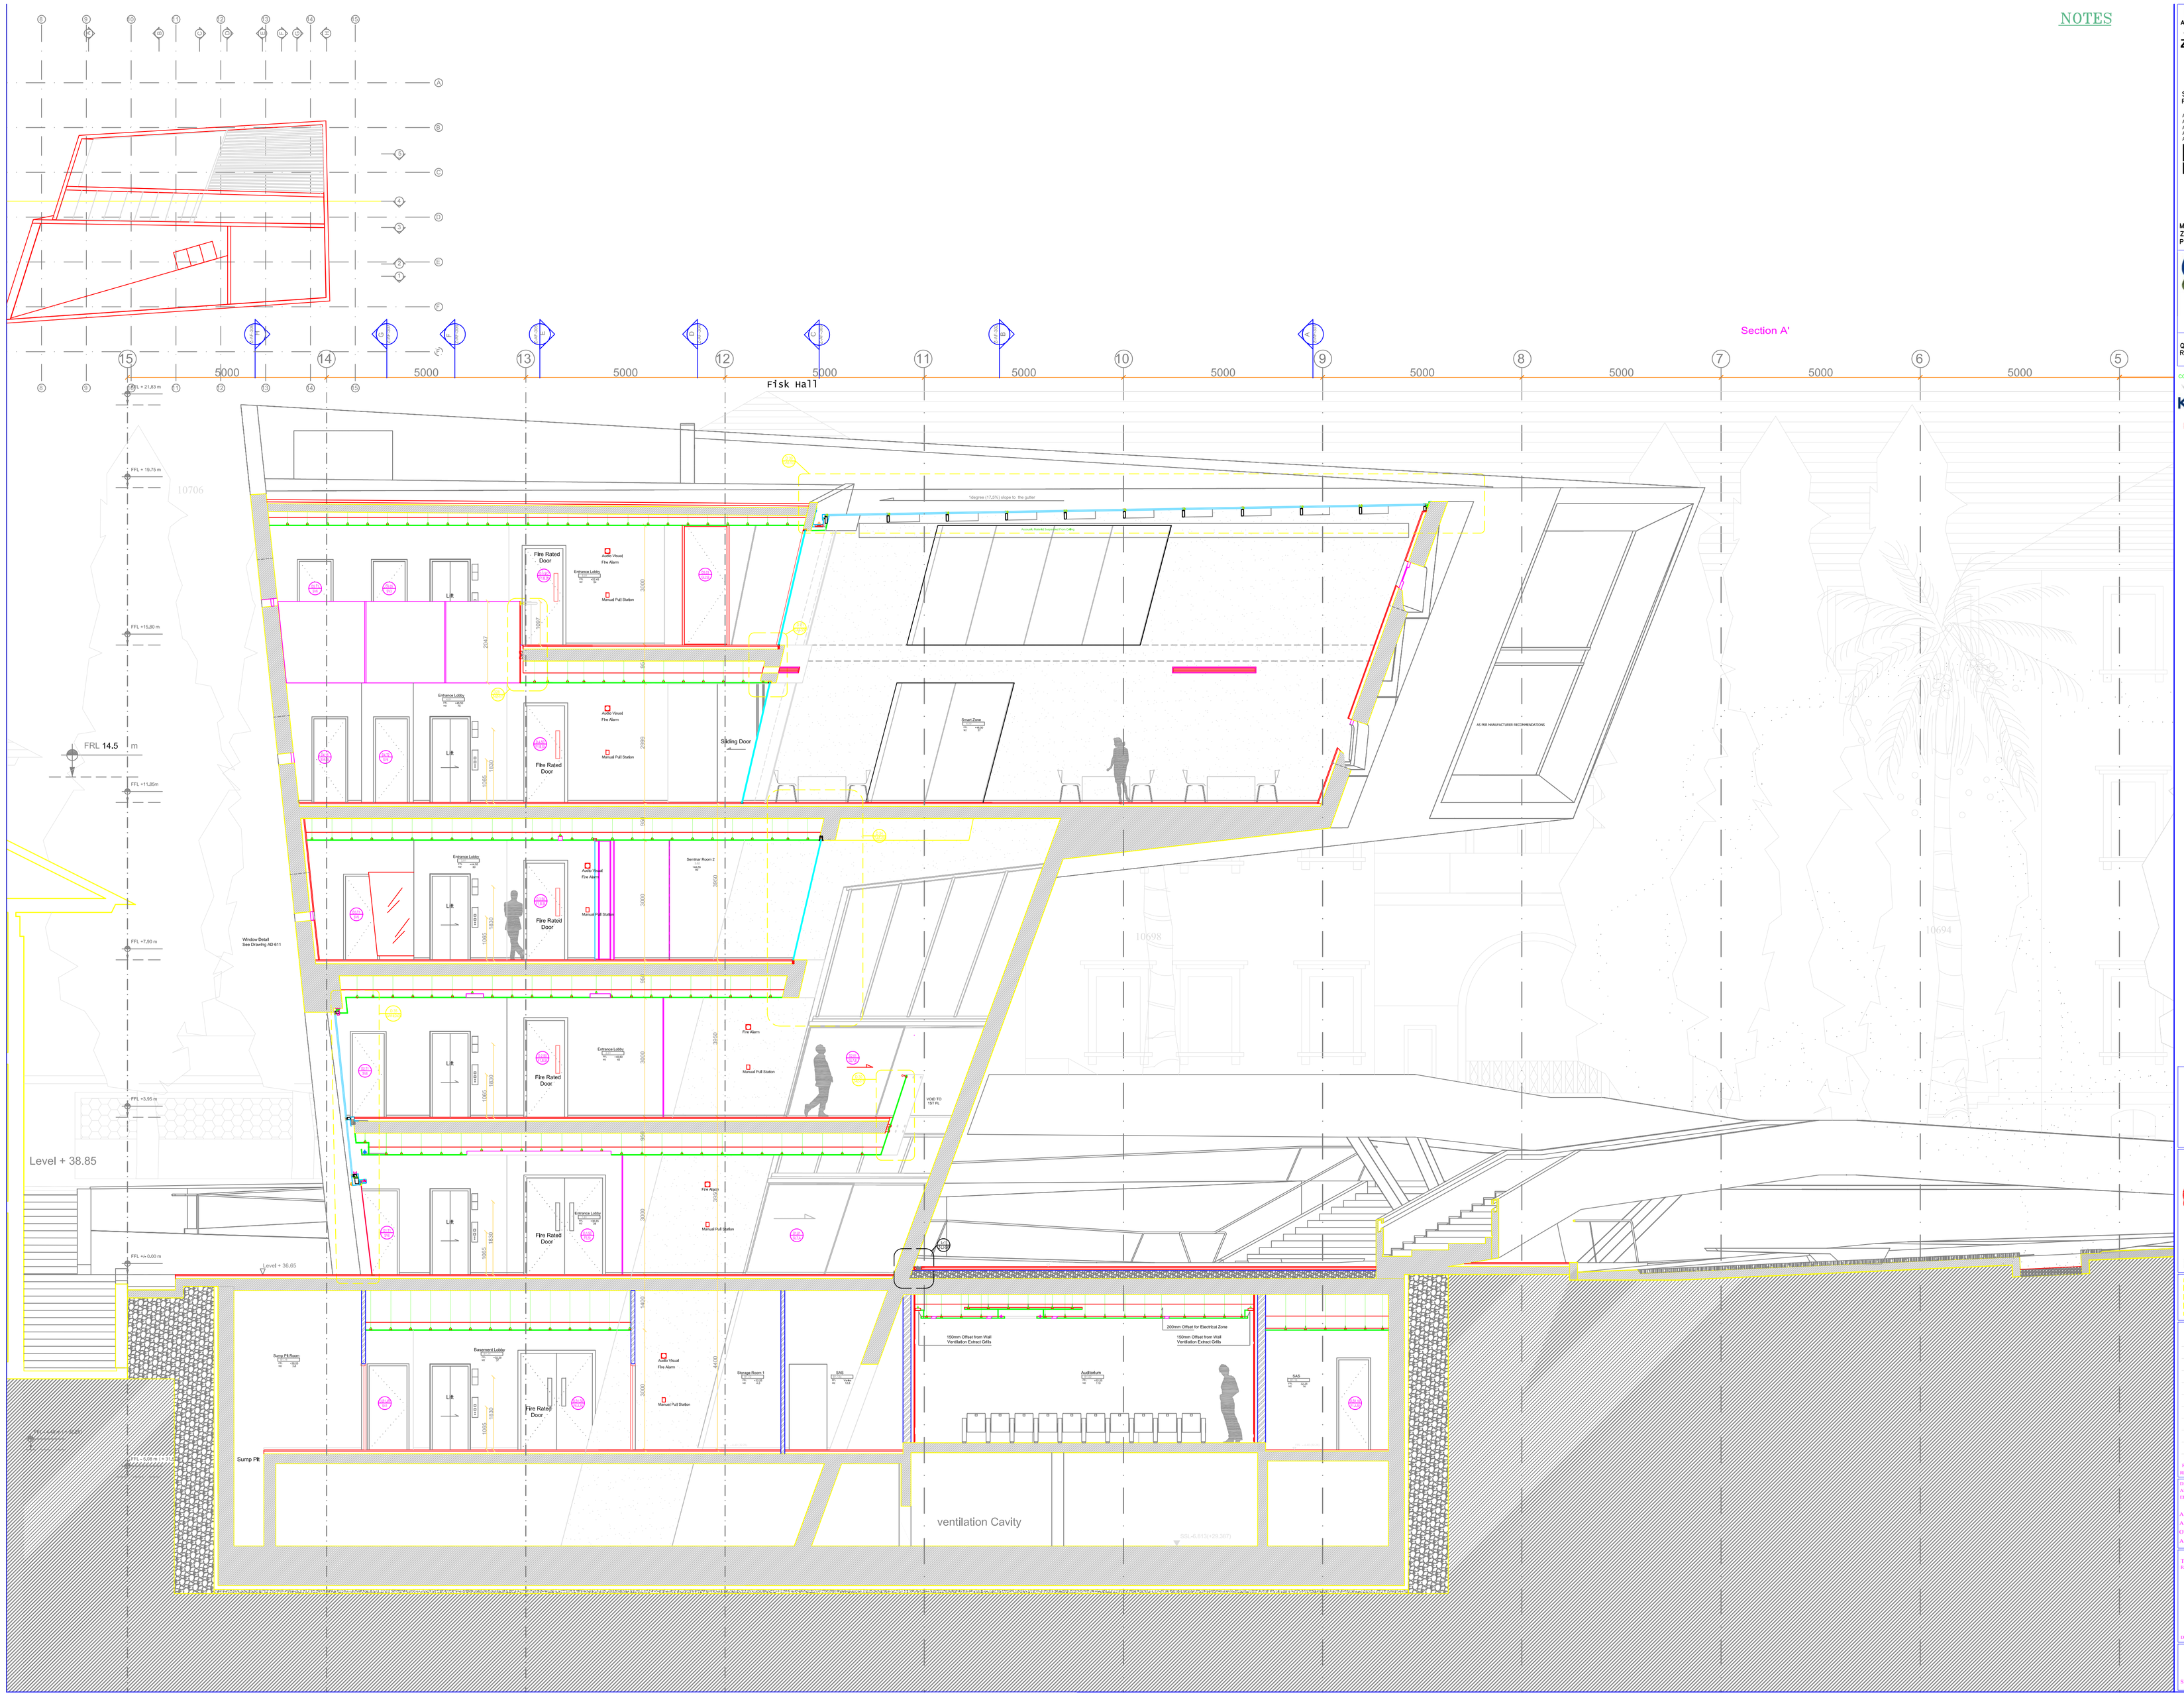

PROJECT NAME
ARCHITECTURAL AND LANDSCAPE DESIGN

ARCHITECT
ZAHA HADID ARCHITECTS

STUDIO 9
10 BOWLING GREEN LANE
LONDON
EC1R 0BQ
UNITED KINGDOM

TEL: 020 7 253 51 47
FAX: 020 7 251 83 22
E-MAIL: ZHA@MAIL.ADDRESS
www.zaha-hadid.com

STRUCTURAL ENGINEERS
RAFIK EL-KHOURY & PARTNERS

ADDRESSLINE1
ADDRESSLINE2
ADDRESSLINE3
ADDRESSLINE4
ADDRESSLINE5

TEL: PHONENUMBER
FAX: FAXNUMBER
E-MAIL: EMAILADDRESS
WEBADDRESS

Rafik El - Khoury & Partners
Consulting — Engineers
RELK&P
P.O.Box: 11-0256 - Beirut
Solar Building
T. & F. +961 1 493 150/1
contact@rafikelkhoury.com

ME&P ENGINEERS
ZEF CONSULTANCY/RAFIK EL-KHOURY & PARTNERS

ZEF (UK) Ltd
1-3 Dufferin Street
London
EC1Y 8NA

Tel: 020 7614 0074
Fax: 020 7614 0076

email: info@zefltd.com
web: www.zefltd.com

SUSTAINABILITY CONSULTANTS & LOW ENERGY ENGINEERS

QUANTITY SURVEYORS
RAFIK EL-KHOURY & PARTNERS

CONTRACTOR
KETTANEH CONSTRUCTION
P.O. Box: 40-339
Tel/Fax: 03-458358
Mob: 03-458358
E-Mail: kettaneh@cyberia.net.lb
Kettaneh Construction S.A.L.
Sub Contractor

American University of Beirut
Facilities Planning and Design Unit

PROJECT NAME:
ISSAM FARES INTITUTE FOR PUBLIC POLICY AND INTERNATIONAL AFFAIRS
PROJECT NO: FPDU-0214

REVISION	DESCRIPTION	DATE
1		03-07-2014
0		09-12-2013

REFERENCE DRAWINGS: GAA_CD_112

DRAWN BY:
ARCHITECTURAL:
ELECTRICAL:
STRUCTURAL:
MECHANICAL:

APPROVAL OF END USER:
APPROVAL OF EHS&RM:
OTHER APPROVALS:
APPROVAL OF FPDU:

TITLE:
REVISION NUMBER:

SECTION
4-4

As-built Drawing
DATE OF DWG:
Drawing Size: A1
SCALE: 1/75

Z-AF-312
SHEET: 1 OF 1
Rev:1